




LEVEL 00 GROUND FLOOR PLAN - WENDELL HALL C
WHITMAN COLLEGE

- | | |
|----------------------------------|--------------------|
| (A) Fisher Hall | (D) Lauritzen Hall |
| (B)(C) Wendell Hall | (S)(E) Baker Hall |
| (T) Murley-Pivrotto Family Tower | (F) 1981 Hall |
| (G) Hargadon Hall | (H) Community Hall |

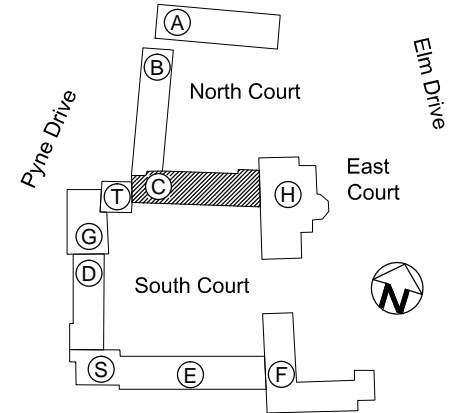

Whitman College Keyplan

REV:	DATE:	SOURCE:
 PRINCETON UNIVERSITY		
Facilities		MacMillan Building
DRAWING 0670-00	PROJECT	
SCALE: 1/16" = 1'-0"	DRAWN: Architect	
VERIFIED		DATE: 08/07
NOT VERIFIED:		SOURCE: Record Dwg