



- | | | | |
|--------|------------------------------|--------|------------------|
| (A) | Fisher Hall | (D) | Lauritzen Hall |
| (B)(C) | North Halls | (S)(E) | South Baker Hall |
| (T) | Murley-Pivrotto Family Tower | (F) | 1981 Hall |
| (G) | Hargadon Hall | (H) | Community Hall |

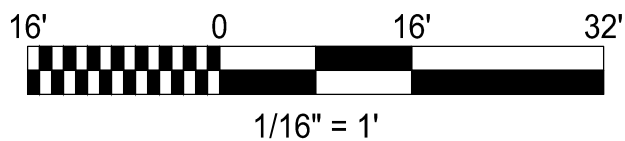

LEVEL 10 FLOOR PLAN
LAURTIZEN HALL

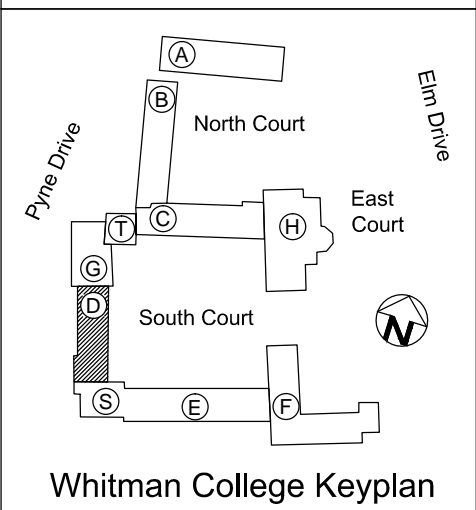

PRINCETON
UNIVERSITY

Facilities

MacMillan Building

DRAWING

0636-01

PROJECT

SCALE: 1/16" = 1'-0"

DRAWN: Architect

VERIFIED



DATE: 6/21/2011

NOT VERIFIED:

SOURCE: Record Dwg